


— PLANNING APPLICATION BOUNDARY  
— OTHER LAND IN APPLICANT'S CONTROL

Copyright Pegasus Planning Group Ltd. Crown copyright. All rights reserved. Ordnance Survey Copyright Licence number: 100020449. Pegasus Licence number: 100020449. Emap/Shea Licence number: 010031973. Standard OS licence rights conditions apply. Pegasus accepts no liability for any use of this document other than for its original purpose, or by the original client, or following Pegasus' express agreement to such use. T: 01285 441717 www.pegasusppg.co.uk


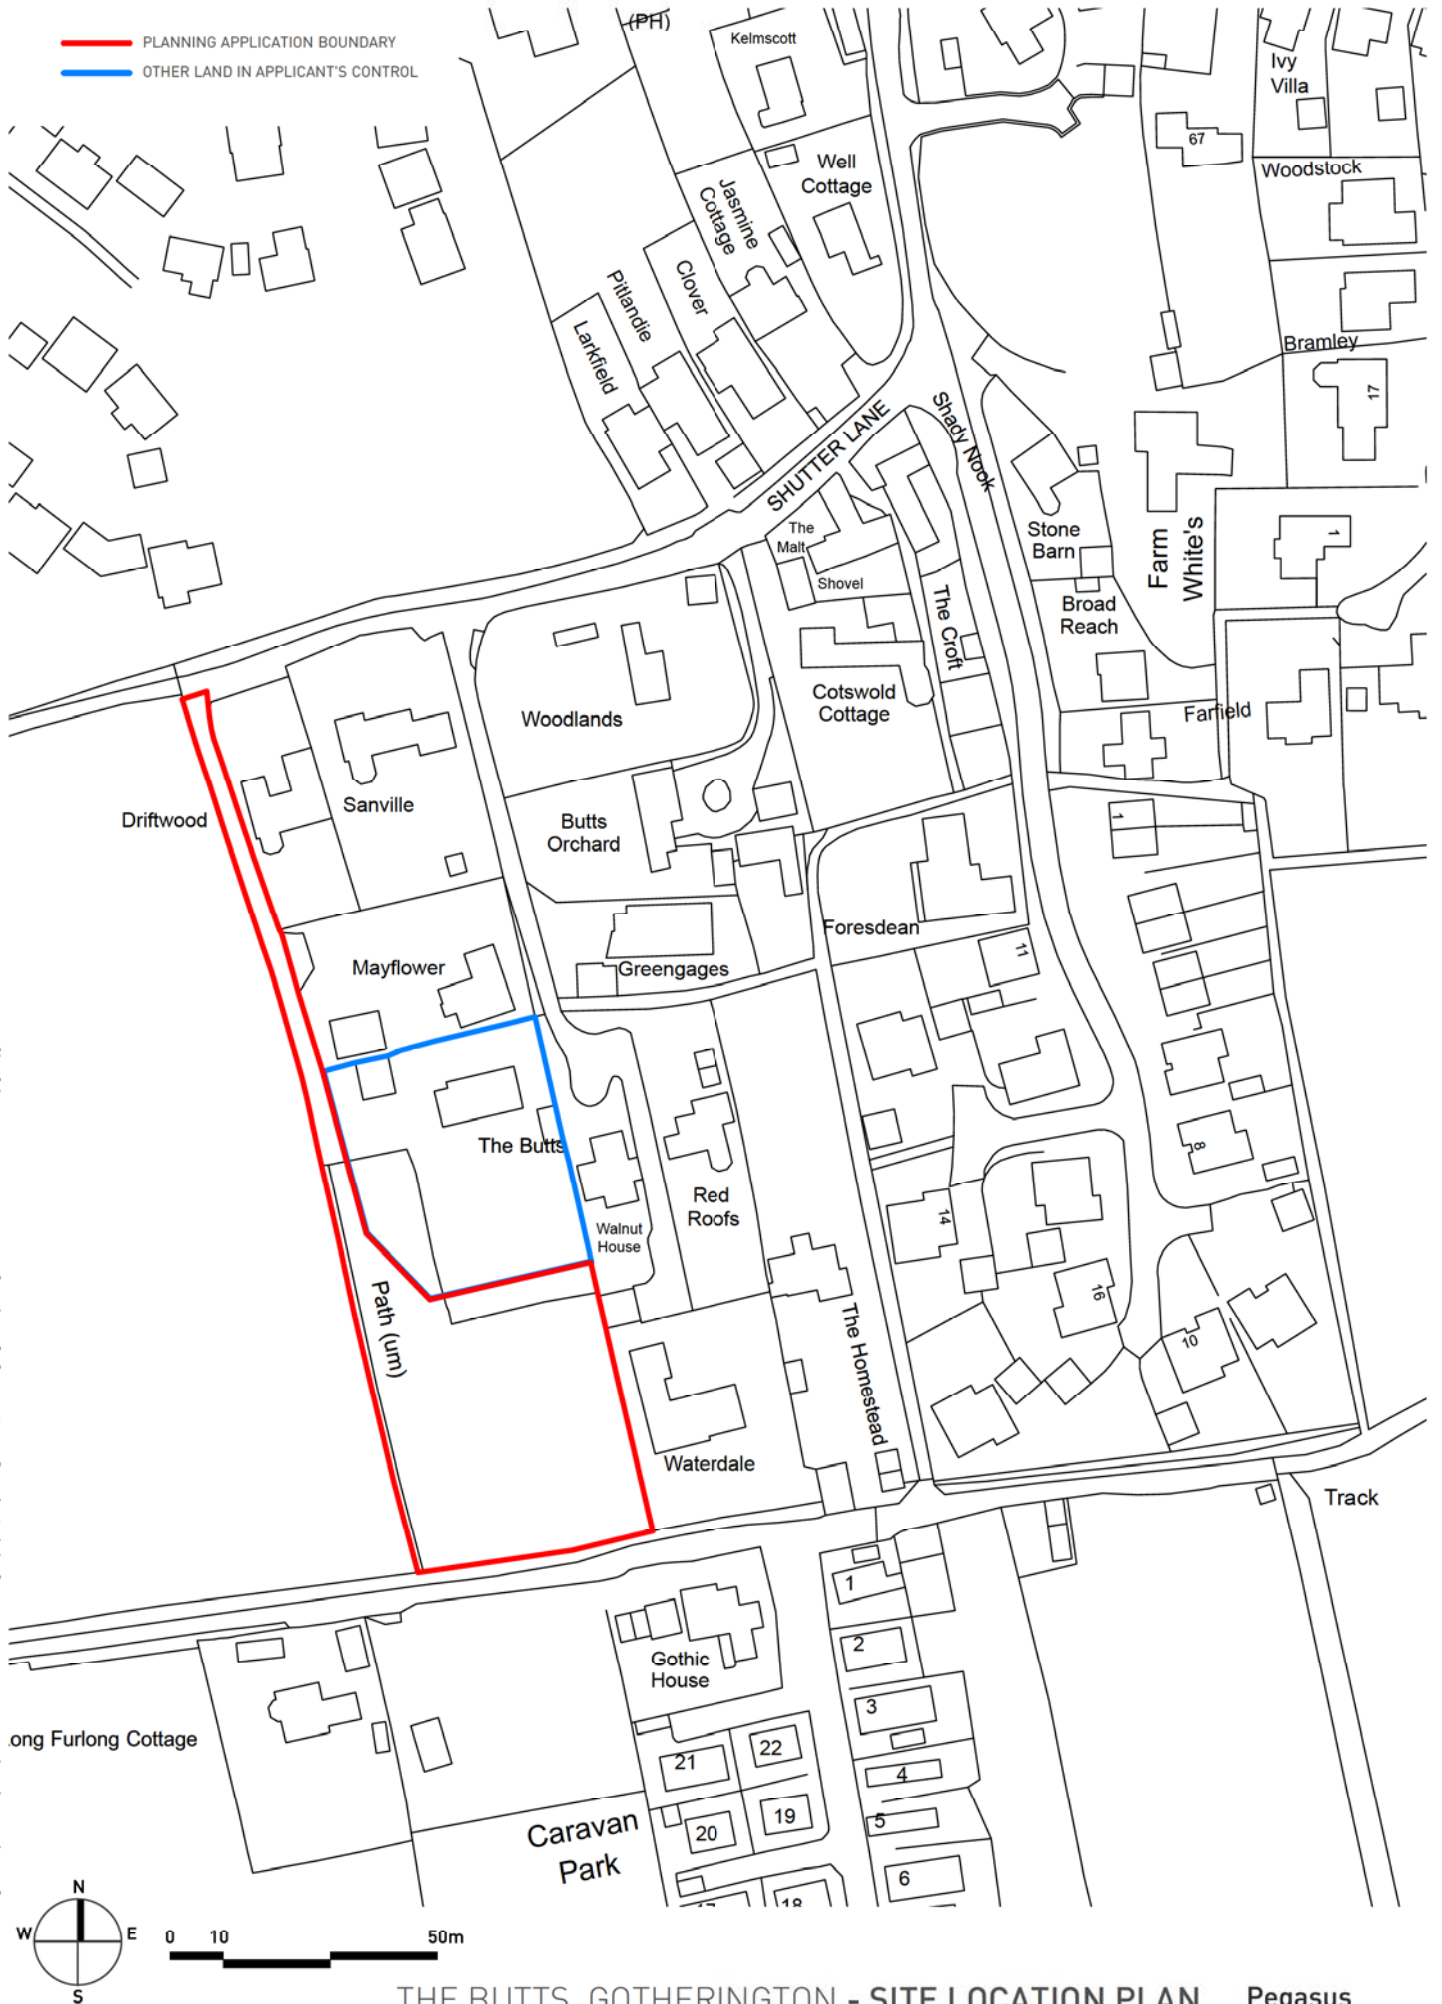


## THE BUTTS, GOTHERINGTON - SITE LOCATION PLAN




| APPROVED BY P.M: EJT | DATE: 9/12/20 | SCALE: 1:1,000 @A3 | DRWG: P20-0963\_01-3 REV: H | CLIENT: CENTAUR HOMES |  
 PLANNING | DESIGN | ENVIRONMENT | ECONOMICS | WWW.PEGASUSGROUP.CO.UK | TEAM/DRAWN BY EJT/KB |

Comparison of red line area between approved plan (left) and proposed plan (right)

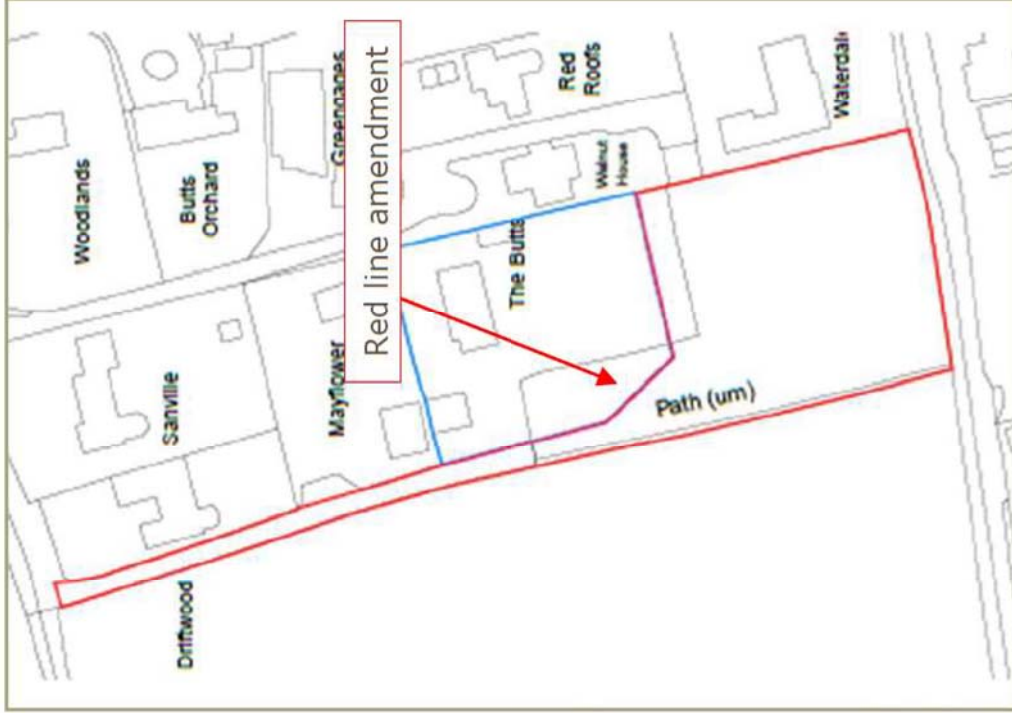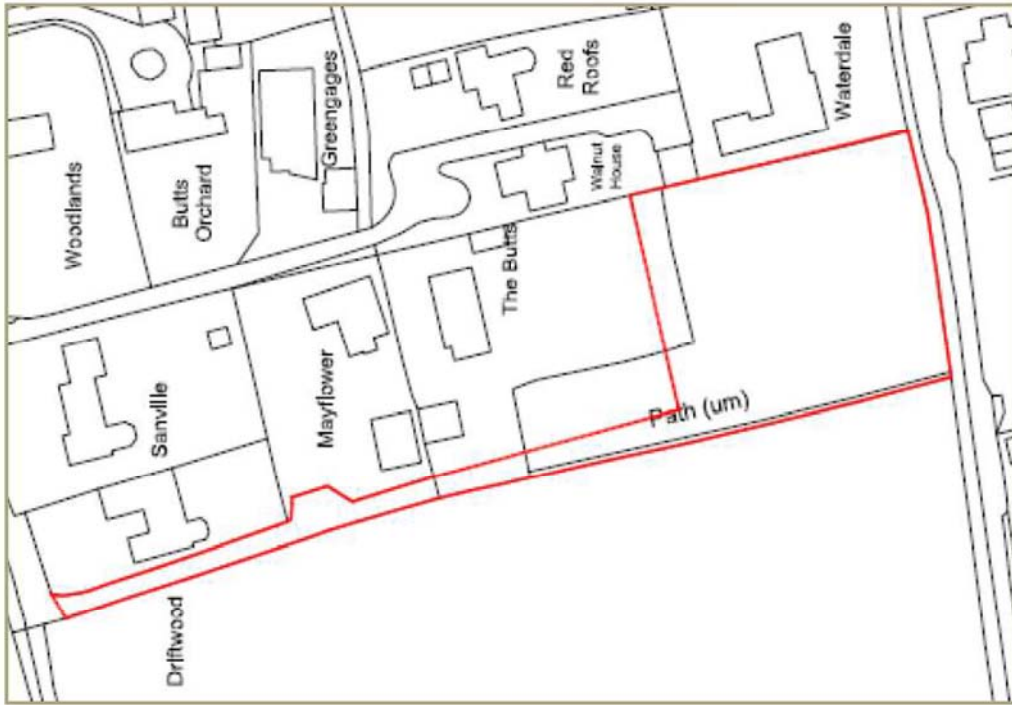



Copyright Pegasus Planning Group Ltd. Crown copyright. All rights reserved. Ordnance Survey Copyright Licence number: 100042693. Pegasus Licence number: 100020444. EmapSite Licence number: 010031673. Standard OS licence rights conditions apply. Pegasus accepts no liability for any use of this document other than for its original purpose, or by the original client, or following Pegasus' express agreement to such use. T: 01286 441717 www.pegasusgroup.co.uk

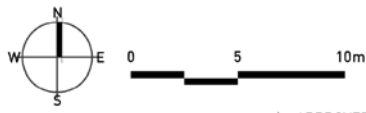


## THE BUTTS, GOTHERINGTON - SITE LAYOUT

| APPROVED BY P.M: EJT | DATE: 4/06/21 | SCALE: 1:250 @ A3 | DRWG: P20-0963\_01-1 REV: i | CLIENT: CENTAUR HOMES |  
 PLANNING | DESIGN | ENVIRONMENT | ECONOMICS | WWW.PEGASUSGROUP.CO.UK | TEAM/DRAWN BY EJT |





Copyright Pegasus Planning Group Ltd. Crown copyright. All rights reserved. Ordnance Survey Copyright Licence number: 100042093. Primary Licence number: 100020449. E-map5 Site Licence number: 0100031973. Standard OS licence rights conditions apply. Pegasus accepts no liability for any use of this document other than for its original purpose, or by the original client, or following Pegasus' express agreement to such use. T: 01285 441717 www.pegasuspg.co.uk

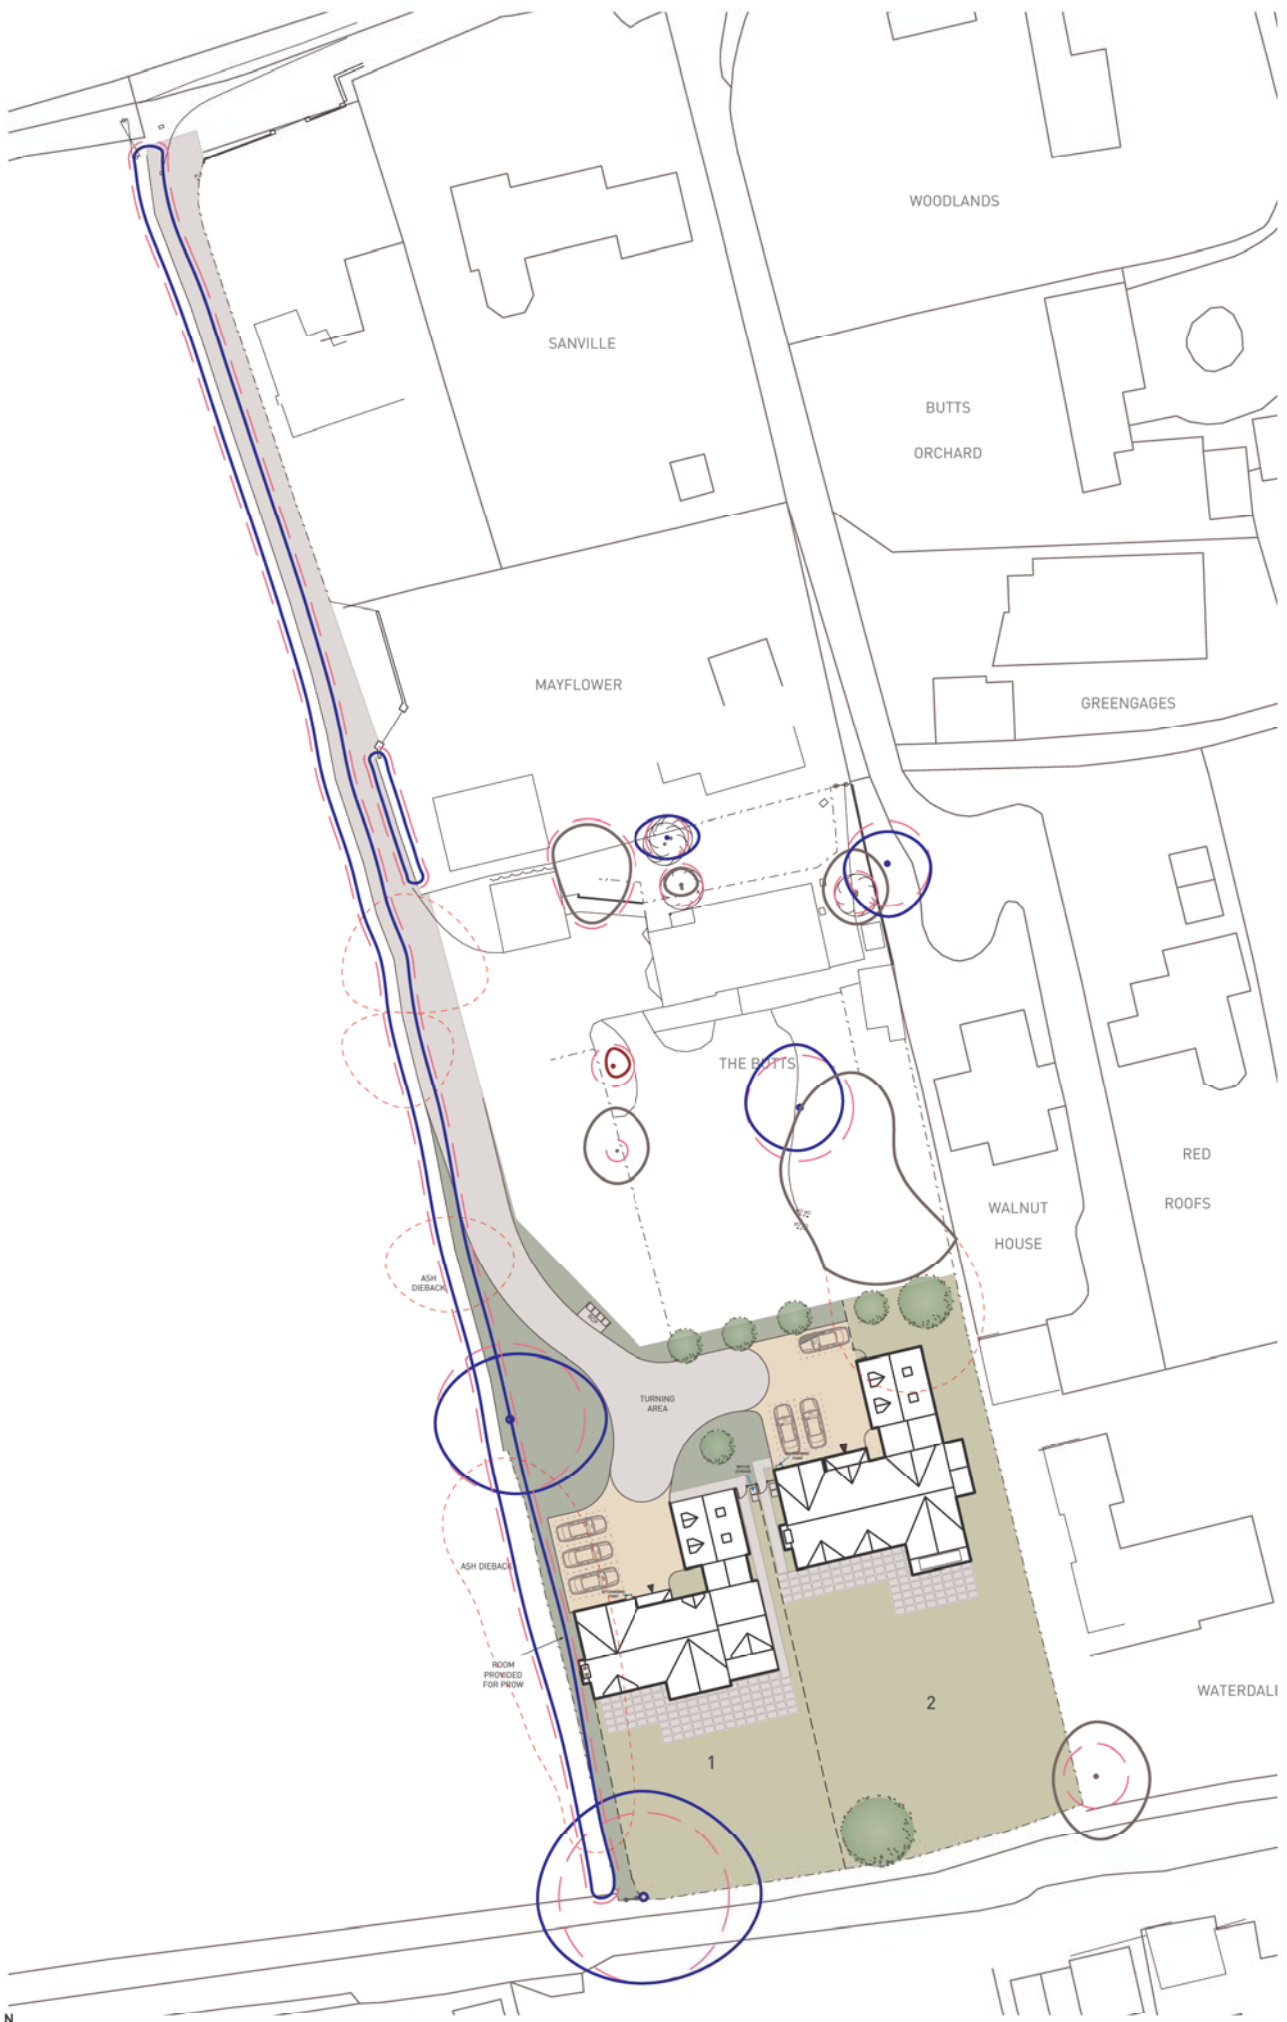

# THE BUTTS, GOTHERINGTON - SITE LAYOUT



| APPROVED BY P.M: EJT | DATE: 9/12/20 | SCALE: 1:500 @A3 | DRWG: P20-0963\_01-2 REV: H | CLIENT: CENTAUR HOMES |  
| PLANNING | DESIGN | ENVIRONMENT | ECONOMICS | WWW.PEGASUSGROUP.CO.UK | TEAM/DRAWN BY EJT/HW |





GROUND FLOOR PLAN



1ST FLOOR PLAN




3140 SQFT


THE BUTTS, GOTHERINGTON - PLOT 01 FLOOR PLANS Pegasus Design

Copyright Pegasus Planning Group Ltd. All rights reserved. No part of this document may be reproduced, stored in a retrieval system, or transmitted in any form or by any means, electronic, mechanical, photocopying, recording, or by any information storage and retrieval system, without the prior written permission of Pegasus Planning Group Ltd. 11220 6177 www.pegasuspg.co.uk



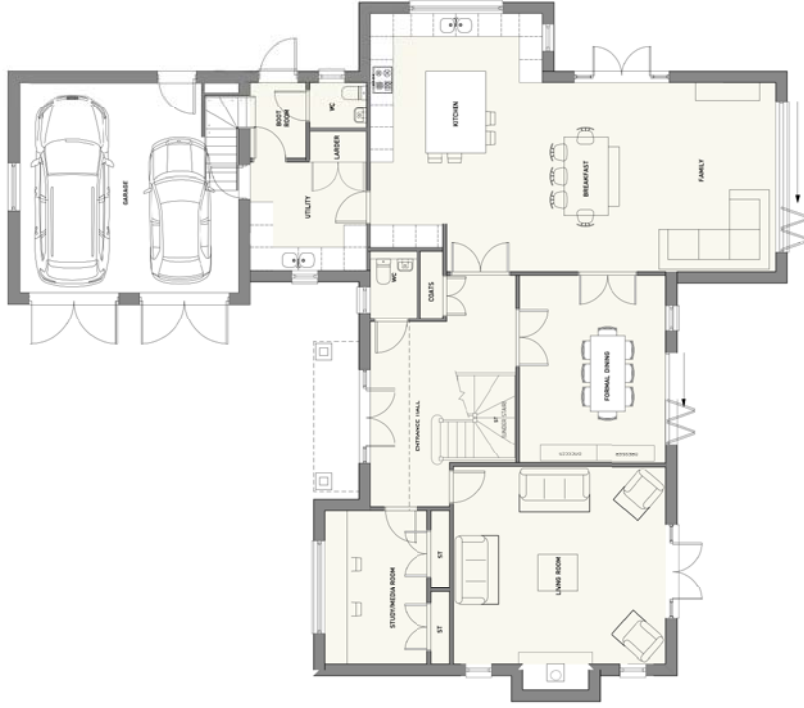

GROUND FLOOR PLAN

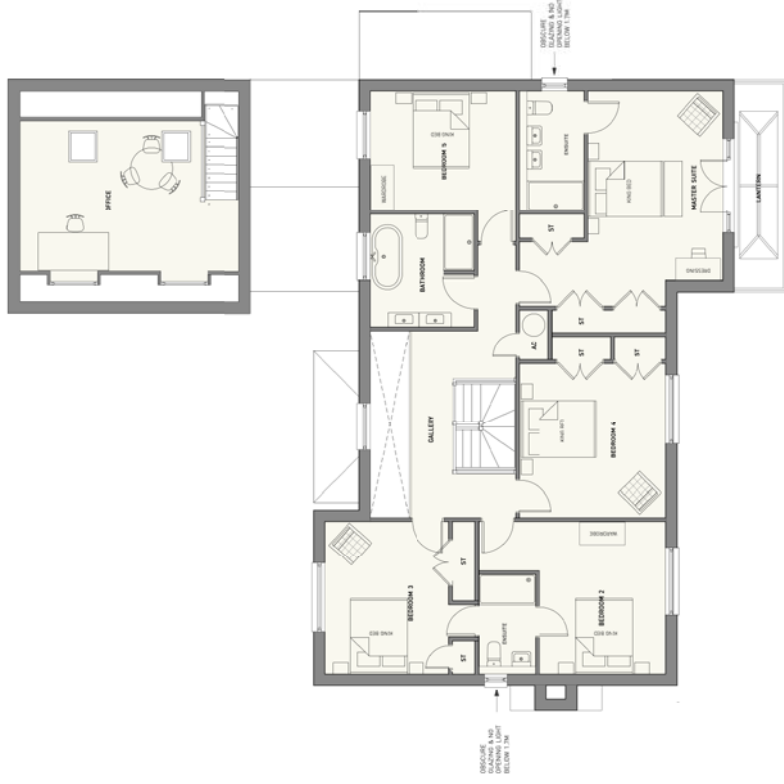

1ST FLOOR PLAN




3330 SQFT

# THE BUTTS, GOTHERINGTON - PLOT 02 FLOOR PLANS


Pegasus Design



PROPOSED CATCHMENT AREA PLAN (1:500)

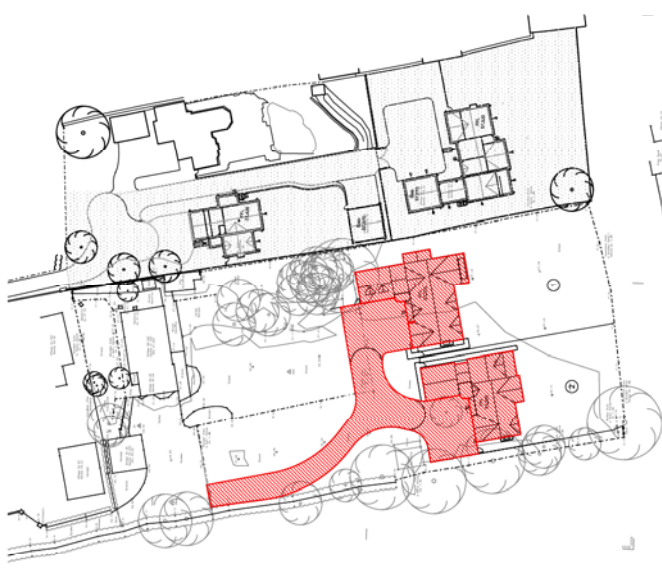

PROPOSED INFILTRATION AREA PLAN (1:500)

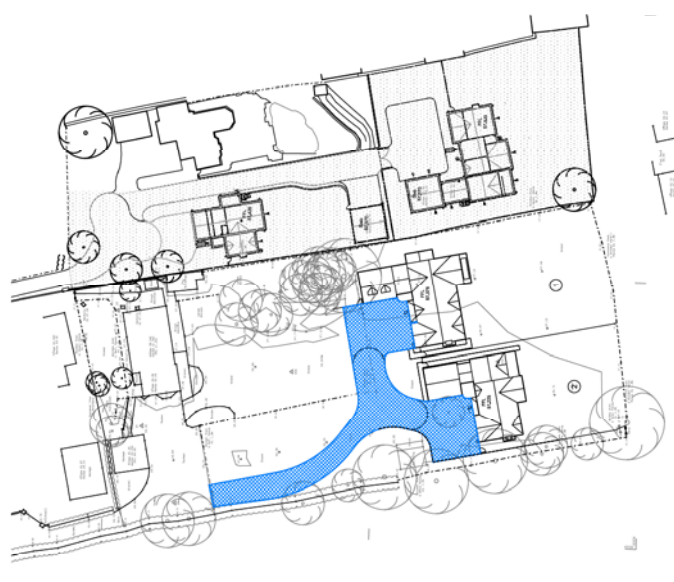

**Important note:**  
All construction works to be undertaken in strict accordance with the Construction (Design and Management) Regulations 2015.

**NOTES:**  
Existing 150mm foul water sewer to be diverted - subject to Severn Trent Water Ltd Section 165 approval.  
Foul water from new plots to drain by gravity to the existing foul water sewer - subject to Severn Trent Water Ltd Section 106 approval.  
Surface water from roofs and driveways to infiltrate into underlying permeable surfaces. Surface water from parking areas to infiltrate into parking areas with 400mm depth of suitable stone (Appropriate Infiltration 'Superficial Surface' or similar) to provide storage prior to infiltration. Infiltration rate taken from previous geotechnical development and assumed to be 1.68mm/hours. Percolation rate will require in-situ testing to confirm.  
Total catchment area (Plots 1, 2 and off-ways) = 512m<sup>2</sup>.  
Total area of permeable surfaces (to provide required storage) = 480m<sup>2</sup>.  
Storm water calculations show design provides suitable storm water storage and holding for a 100 year event +45% for climate change.  
Permeable surfaces to be maintained in accordance with CRESA Study Manual C753.  
Storm water harvesting to be provided for the form of rain water butts to reduce demand for potable water.


**MANS DRAINAGE KEY:**  
 - - - Existing foul manhole / sewer  
 - - - Adaptable foul manhole / sewer  
 - - - Foul sewer to be abandoned  
 - - - Foul lateral / demarcation chamber  
 - - - Proposed 'polywater' permeable paving inlet / outlet  
 - - - Private foul drain  
 - - - Private foul drain  
 - - - Water butt with overflow to piped system  
 - - - Easement for existing public sewer

**EXTERNAL WORKS KEY:**  
 - - - Unbound gravel  
 - - - Permeable block paving  
 - - - Proposed 150mm foul water storage to allow infiltration




REVISIONS	Date:	By:
1	20/11/20	BDP

Figure 6- Gotherington Neighbourhood Plan Proposals Map (OS Licence Number: 100055181)

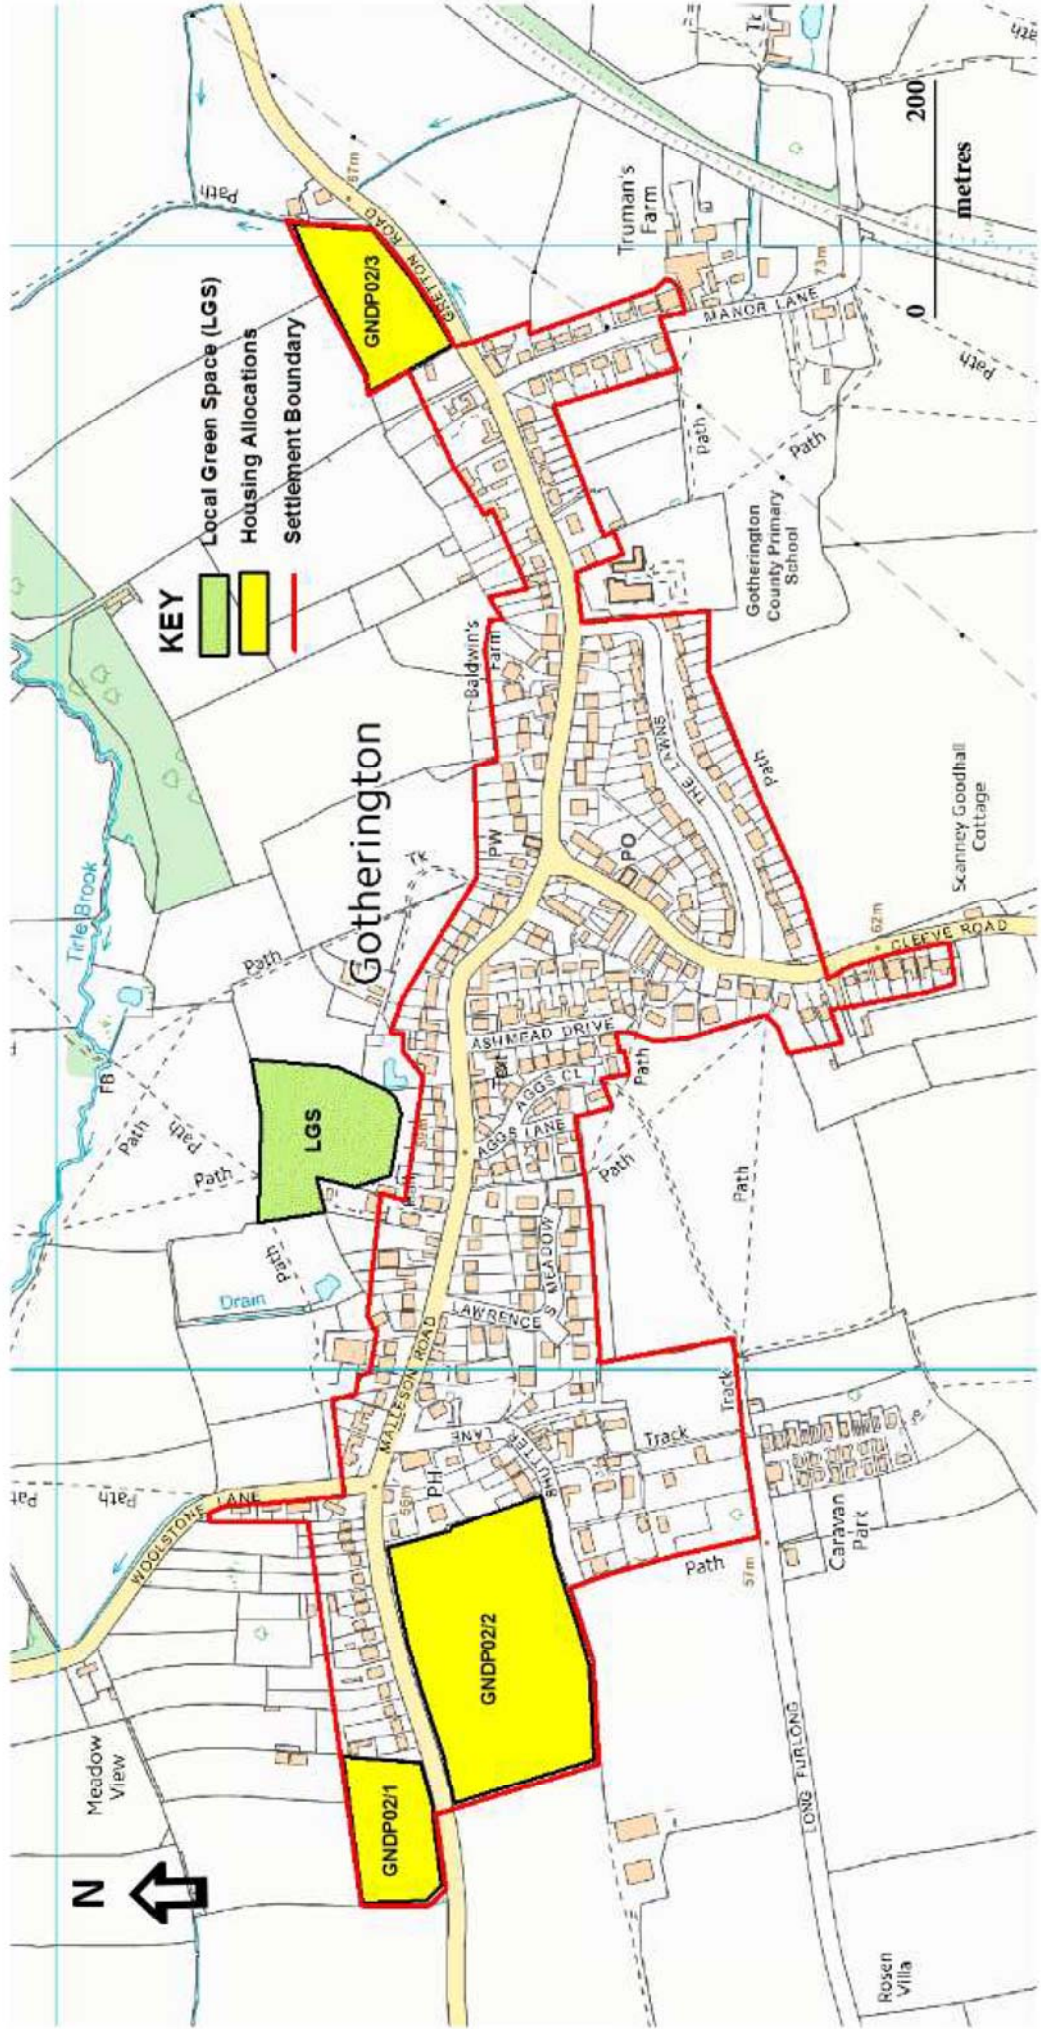




**RES1 & RES2 - Gotherington**

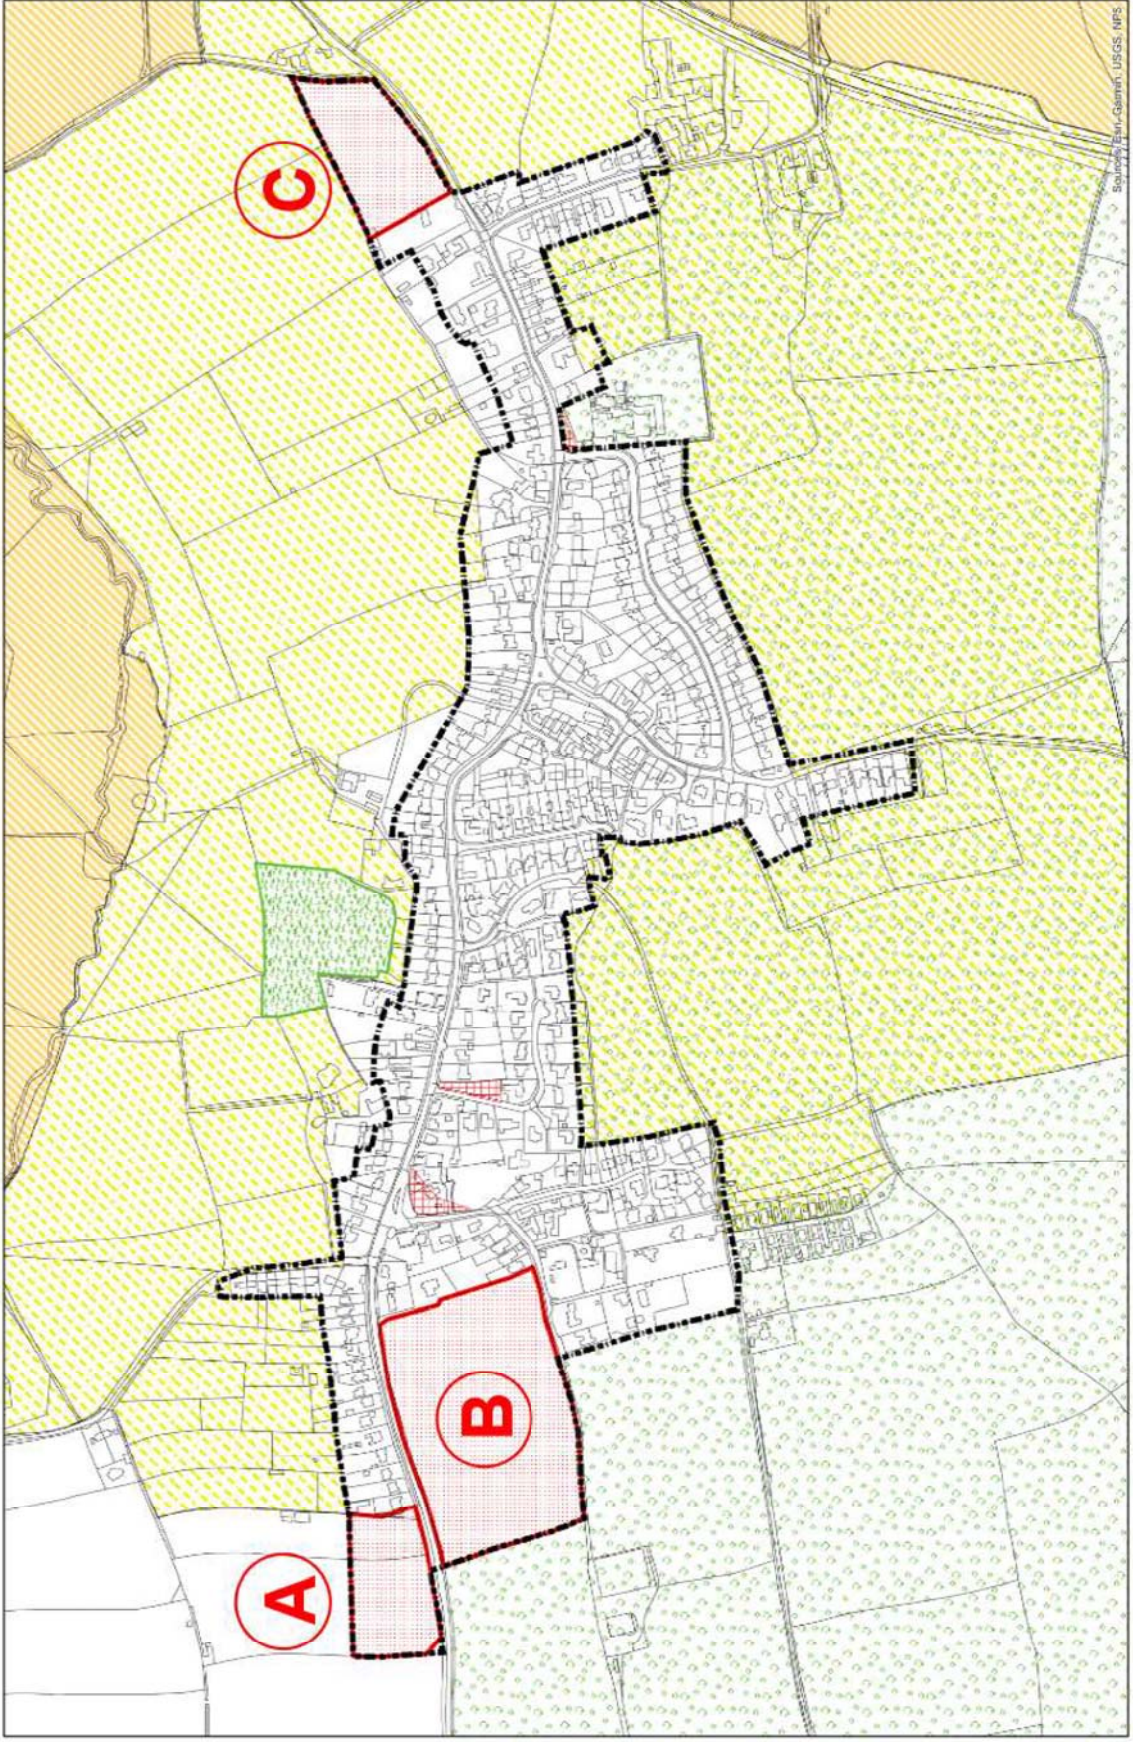






**Nowdig Illustrative Section**

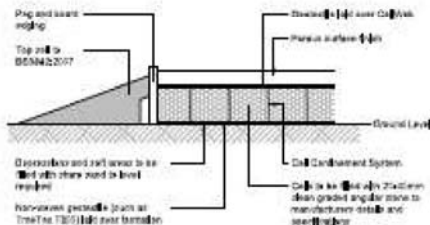

**Protective Barrier Type 1**

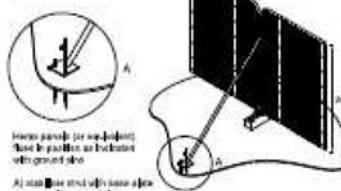

**Quality and Suitability For Retention**



**Root Protection Areas (RPA)**

Root Protection Areas (RPA) are defined as the area around a tree trunk to protect its roots from excavation work.




**Group / Area / Woodland / Hedge Key**

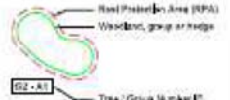

**Key**

- Tree to be removed
- Tree Protection Barrier Type 1
- Area at risk of excavation
- Groups / Woodland / Hedge / No Access

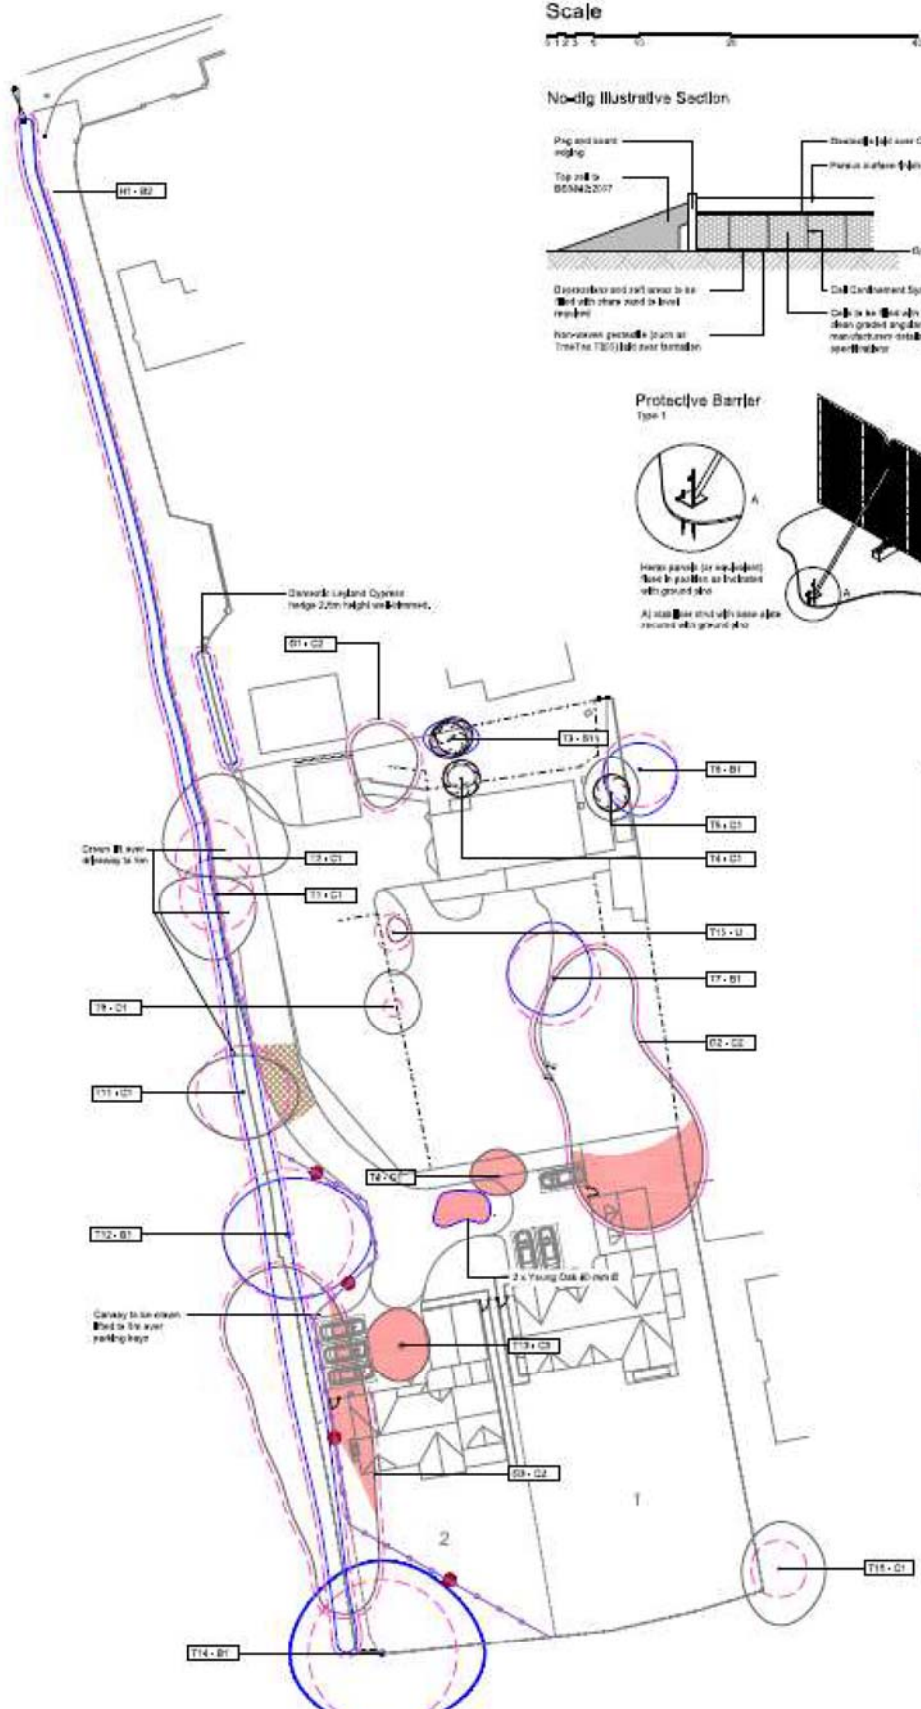

\*Water nearby denotes earth retention

**Notes**

- 1) Survey Date 28th September 2025.
- 2) This survey has been conducted to be plotted in colour. If you have been given this drawing in monochrome please request a colour version.
- 3) Do not scale directly from this drawing.
- 4) This survey is to be used in conjunction with all other relevant site drawings and information supplied by other consultants.

Client	
Project	The Butts, Gotherington
Location	
Date	20/09/2025
Drawn by	
Checked by	
Scale	
Sheet No.	

**The Butts, Gotherington  
AIA and Tree Protection Plan**

